



Existing Easements

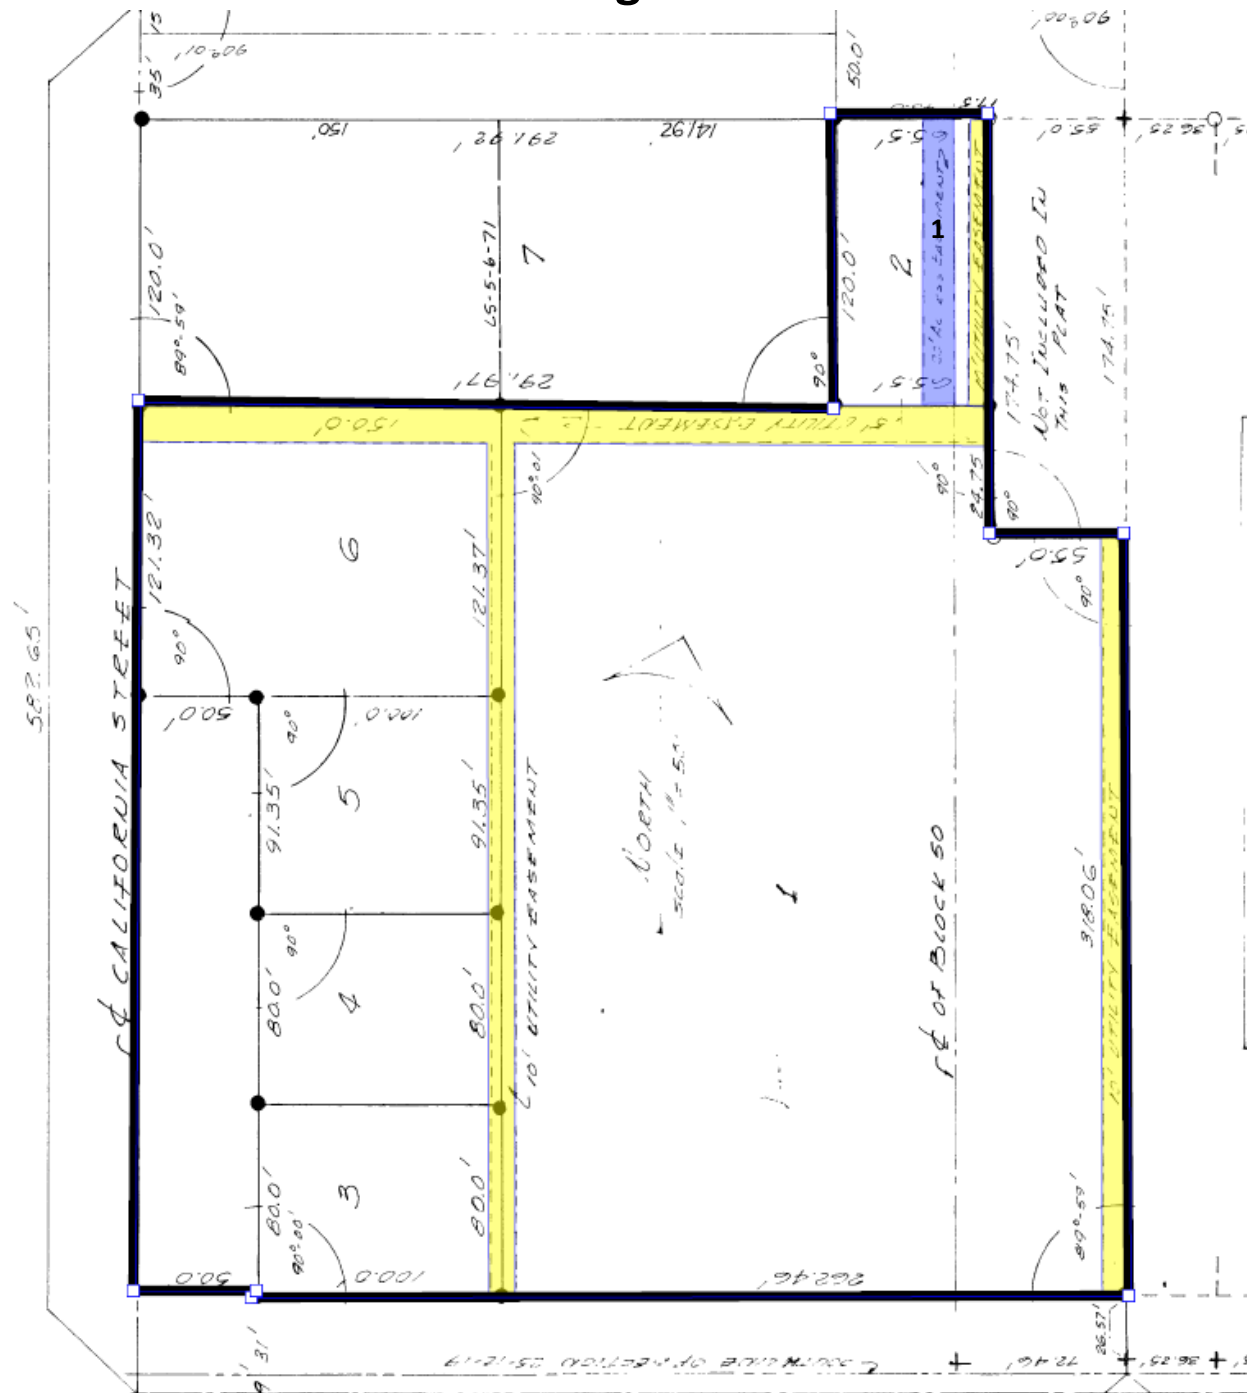

- Existing 20' access easement to be vacated shown in blue.

Proposed Easements

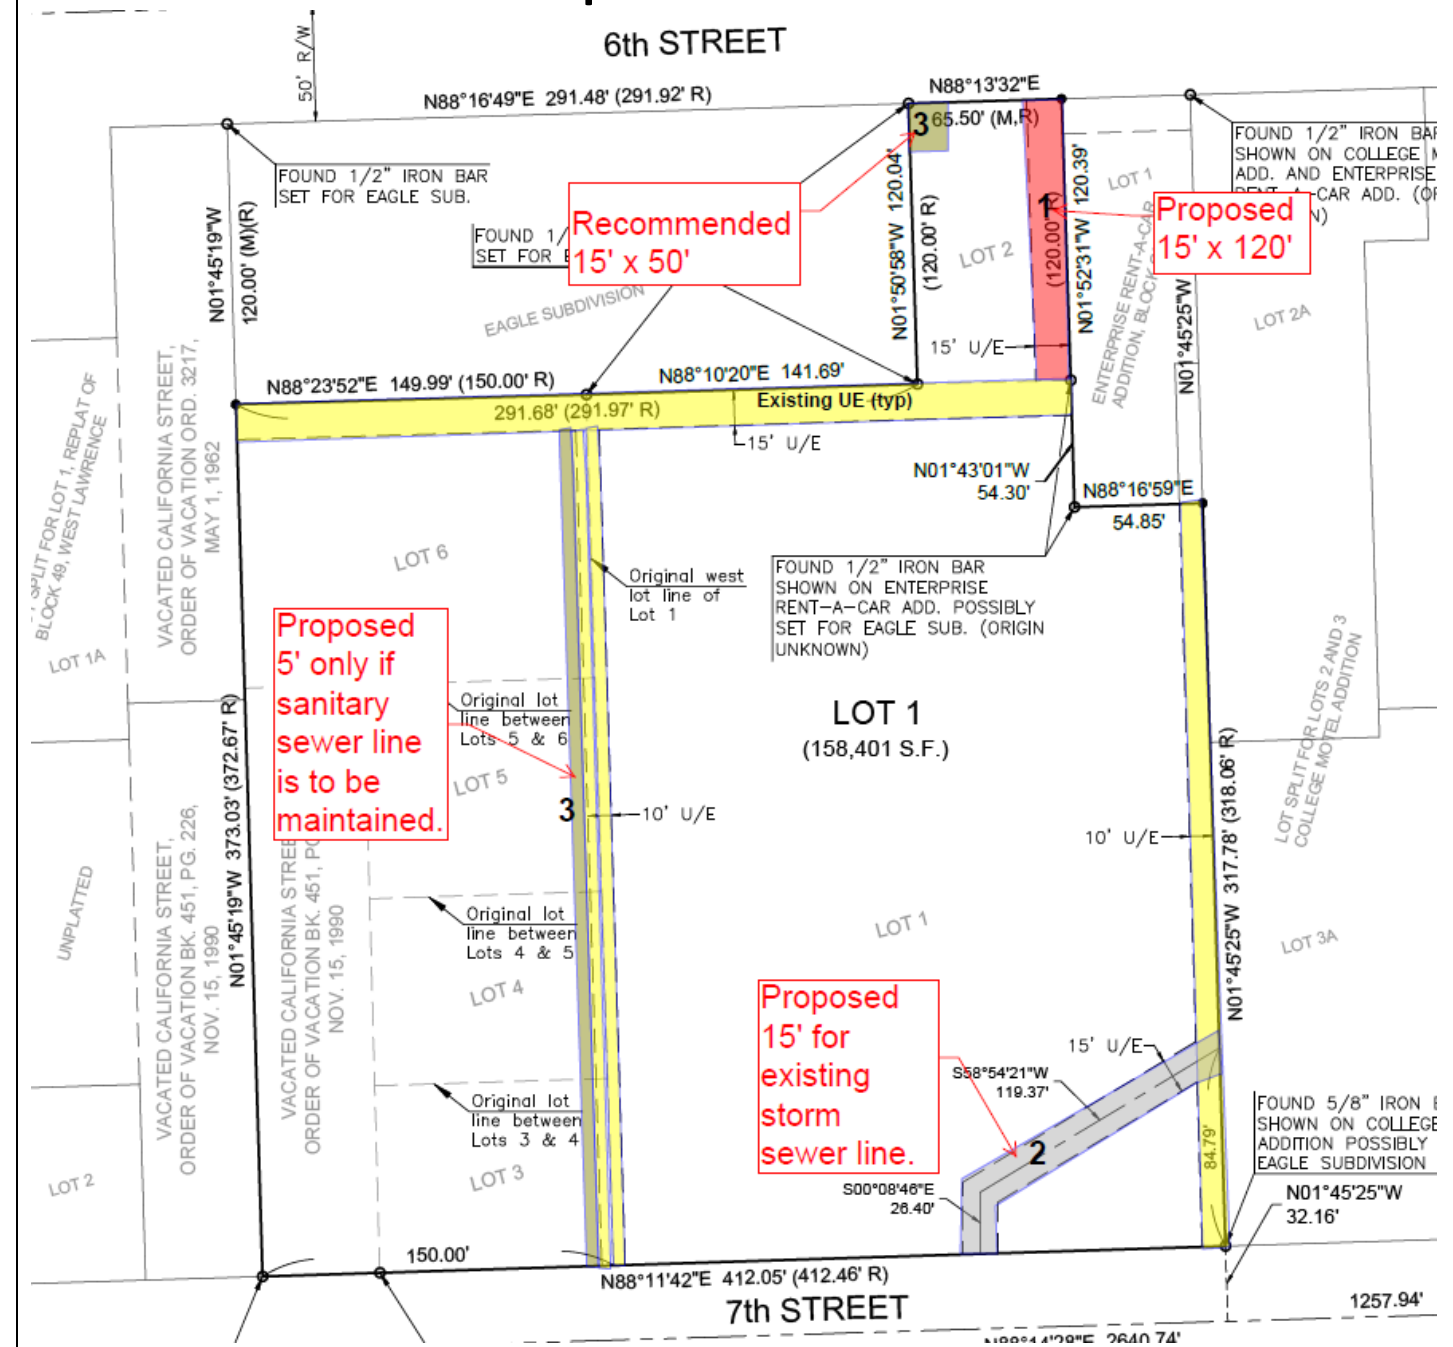

- New 15' utility easement to be dedicated shown in red.
- General location of storm sewer easement to be dedicated shown in gray.
- Recommended utility easements shown in gold.